


KEY	
EXISTING LEVELS.	52.846
PROPOSED LEVELS.	+54.38
1800MM HIGH TIMBER SINGLE BOARDED FENCE	
1000MM WIDE TIMBER GATE	
1100MM HIGH GALVANISED MILD STEEL RAILINGS WITH RETAINING STRUCTURE BELOW	
EXISTING BOUNDARY WALL	
EXISTING BOUNDARY WALL TO BE ALTERED	
1200MM HIGH MODULAR RETAINING WALL	
2500MM HIGH BUTTRESS WALL - TO SE'S DETAILS	
RETAINING WALL WITH 310MM MASONRY CAVITY WALL TO FORM NEW SHED	
RETAINING WALL WITH 1800MM HIGH TIMBER FENCE	
BLOCK WORK RETAINING WALL TO SE'S DETAILS	
RETAINING KERB WITH 1800MM HIGH TIMBER FENCE	
APARTMENT ENTRANCE	
APARTMENT BLOCK	
NEW SHED	
BARK FINISH AREA WITH SHRUB PLANTING	
LANDSCAPING STRIP	
BRUSHED CONCRETE TO PATHS, BIN STORES & CYCLE PARKING	
BRICK PAVING FEATURE TO COMMUNAL GARDEN	
BITMAC AREAS	
ASPHALT TO PARKING AREA	
TREES (refer to Landscape dwg)	

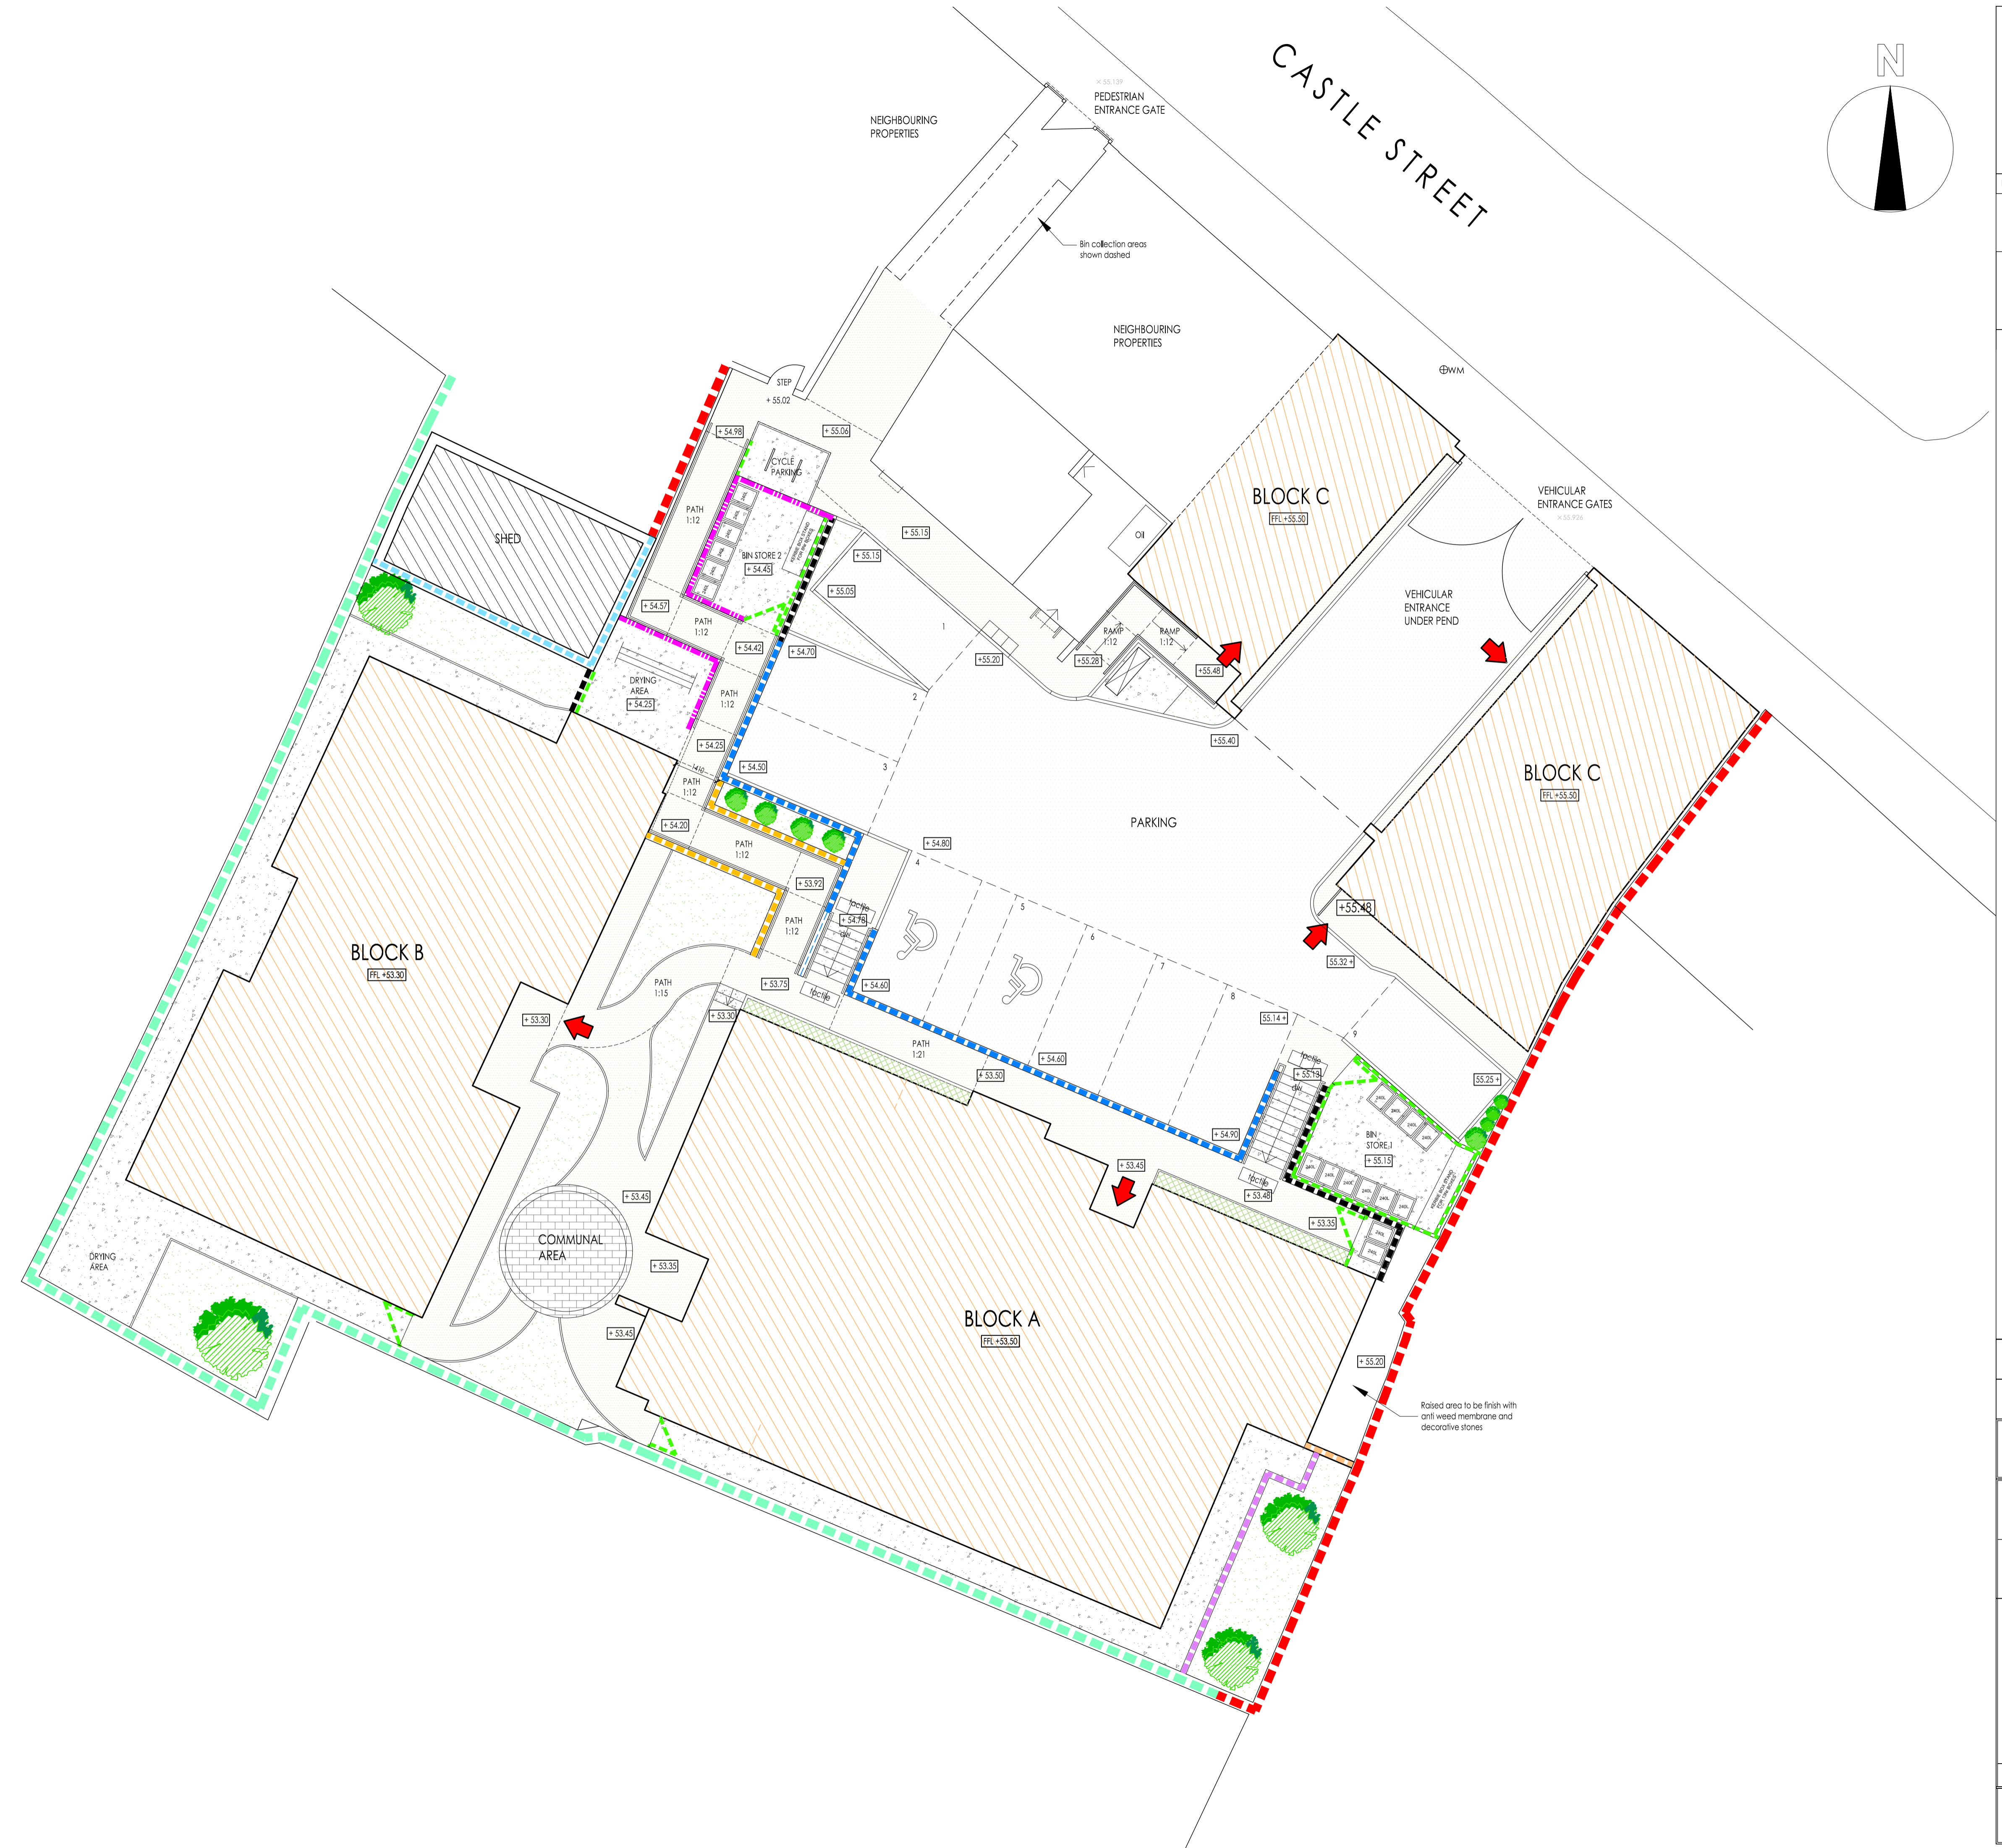

KEY PLAN		
HEALTH SAFETY AND ENVIRONMENTAL INFORMATION		
It is assumed that all works on this drawing will be carried out by a competent contractor working, where appropriate, to an appropriate method statement.		
ADDITIONAL INFORMATION:		
NOTES:		
SCALES @ A1	ISSUING OFFICE	PROJECT NUMBER
1:100	BELFAST	4712
PURPOSE OF ISSUE		STATUS
AS BUILT		AB
CLIENT		
FORMME CONSTRUCTION LTD		
PROJECT		
APARTMENT DEVELOPMENT AT CASTLE STREET, BALLYMENA		
TITLE		
SITE PLAN		
ARCHITECTS . PLANNERS . PROJECT MANAGERS		
2nd FLOOR, ALFRED HOUSE, 21 ALFRED STREET, BELFAST, B12 8ED		30 NORTHWOOD COURT, NORTHWOOD SANTRY, DUBLIN 9
TEL: +44 (0)28 9044 5930		TEL: +353 (0) 1894 0100
E: initialsurname@jwp-architects.com		
DRAWN BY	DATE	CHECKED BY
MM	02.03.20	CL
DRAWING NUMBER	SCALE	REVISION
4712-AB-10	1:100 @ A1	-